

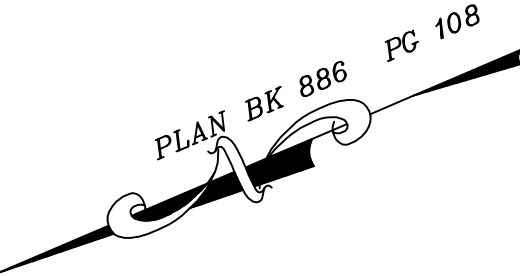



DEED REF. BOOK: 44980 PAGE:115  
 PLAN BOOK: 886 PLAN:108  
 PLAN BOOK: 944 PLAN:64  
 RECORDED © WORC. CNTY REGISTRY OF DEEDS

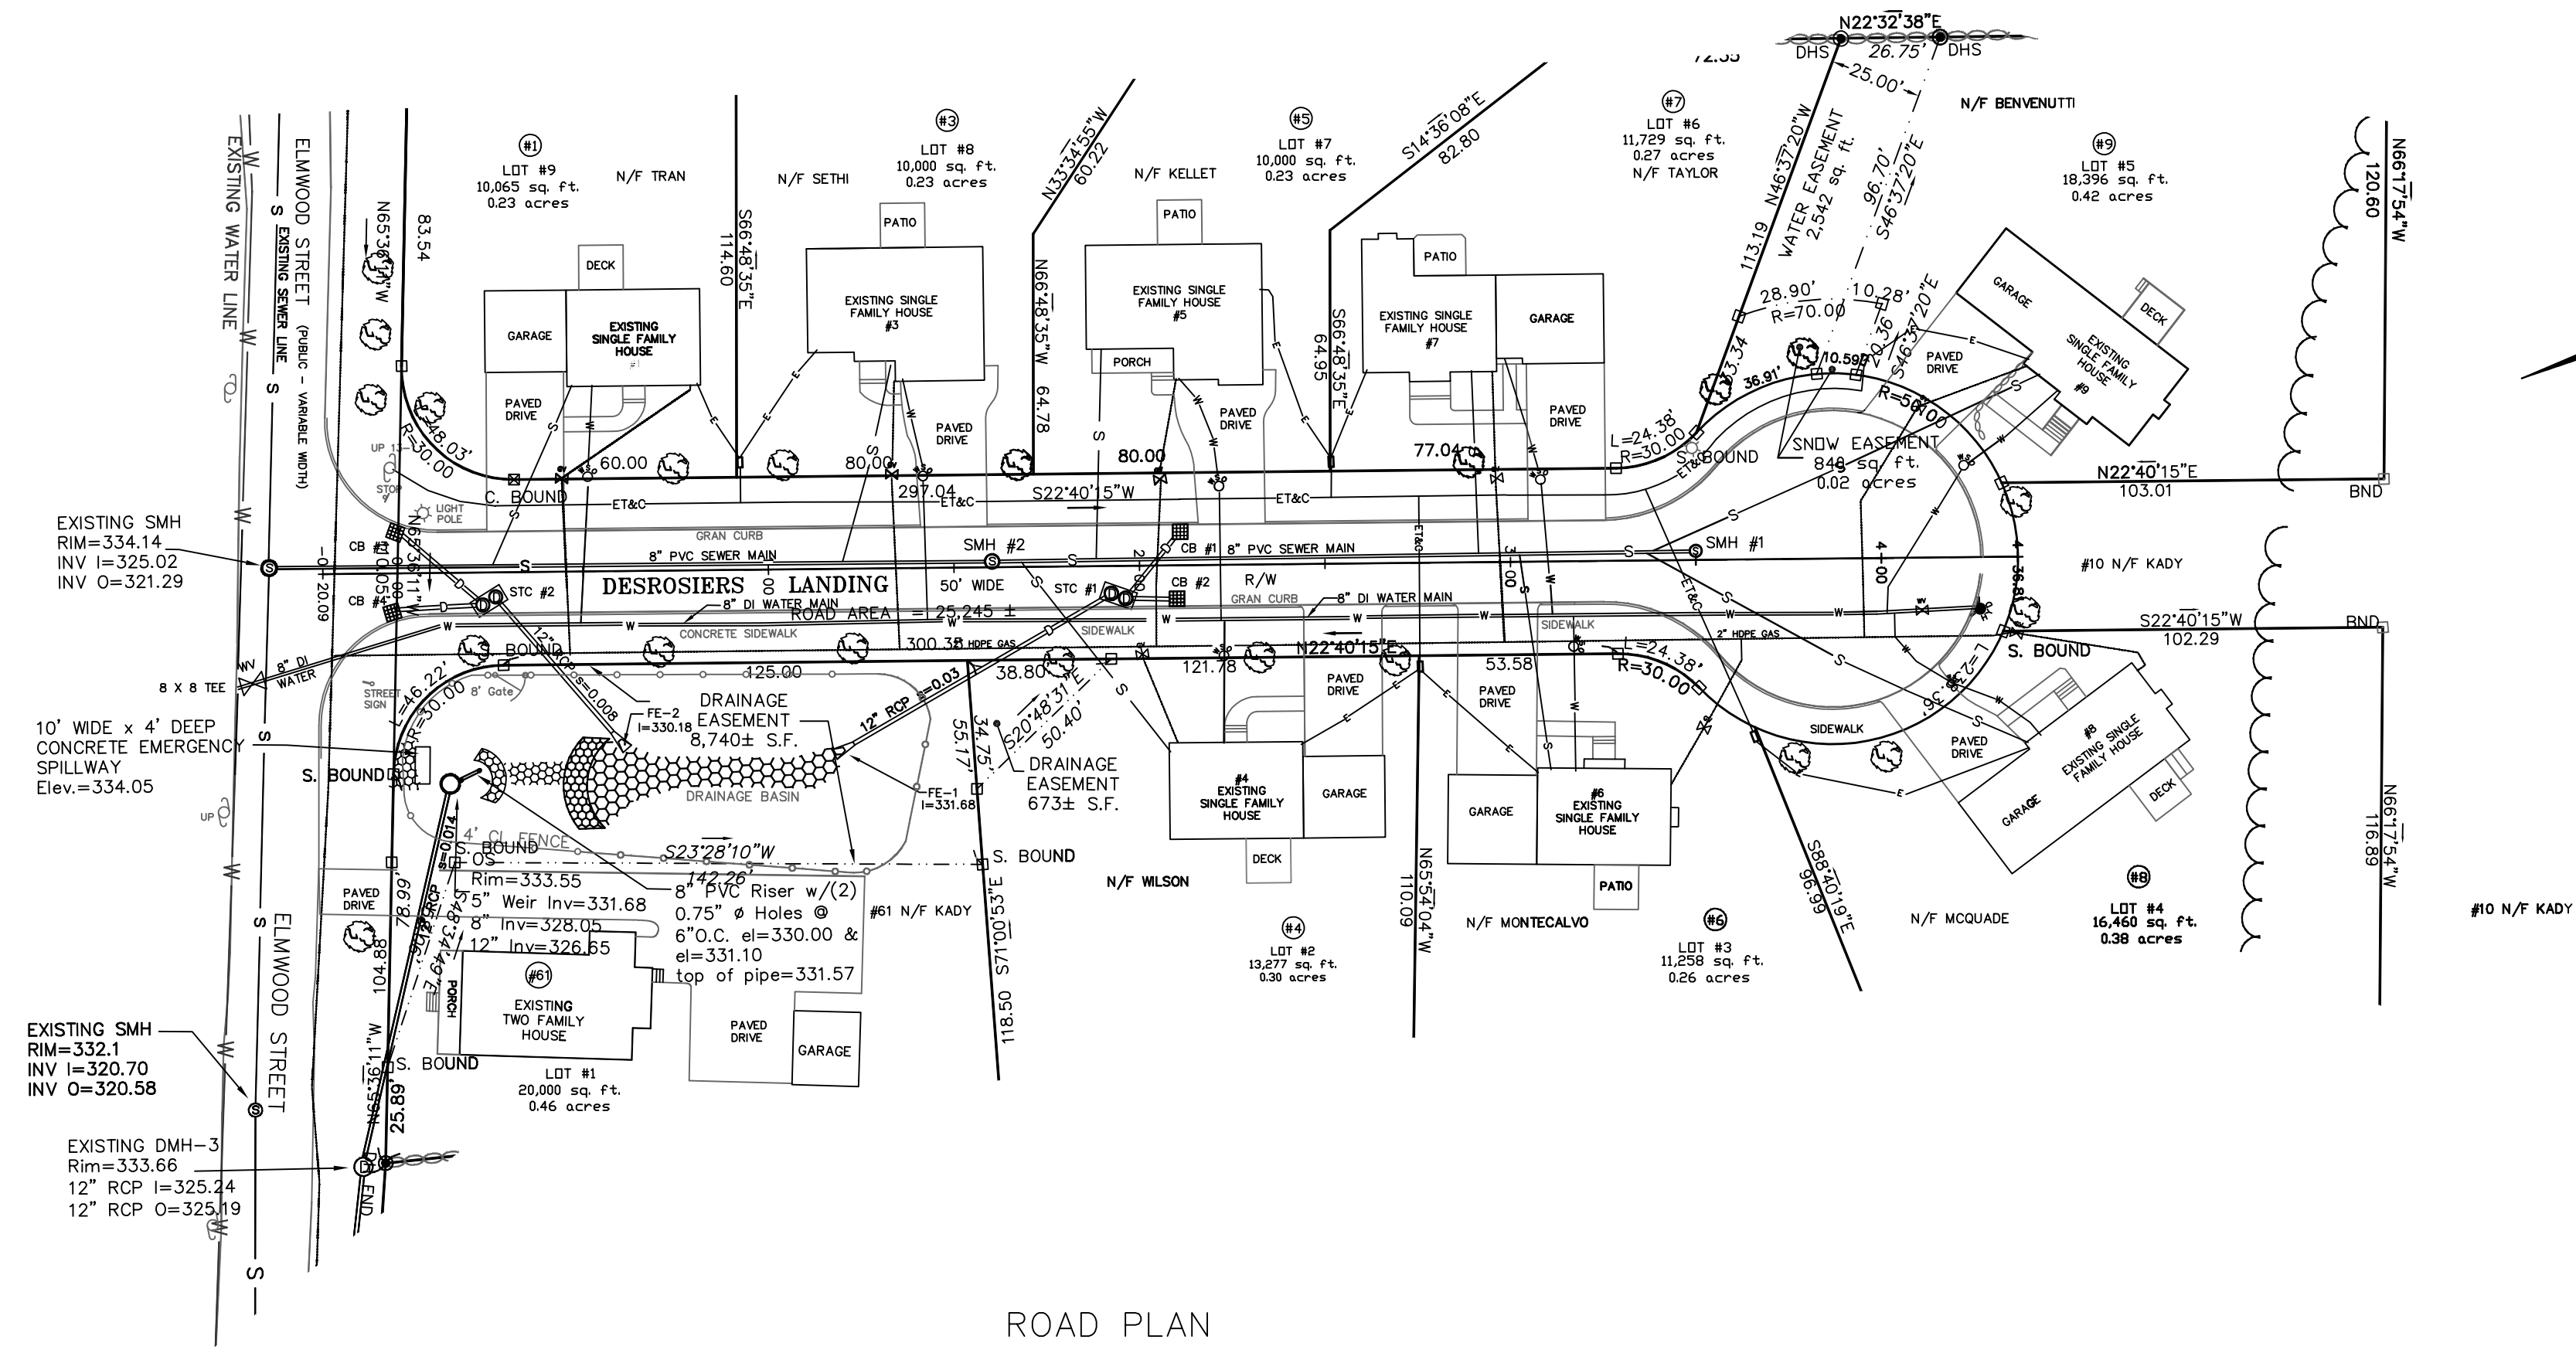

FOR REGISTRY OF DEEDS USE ONLY

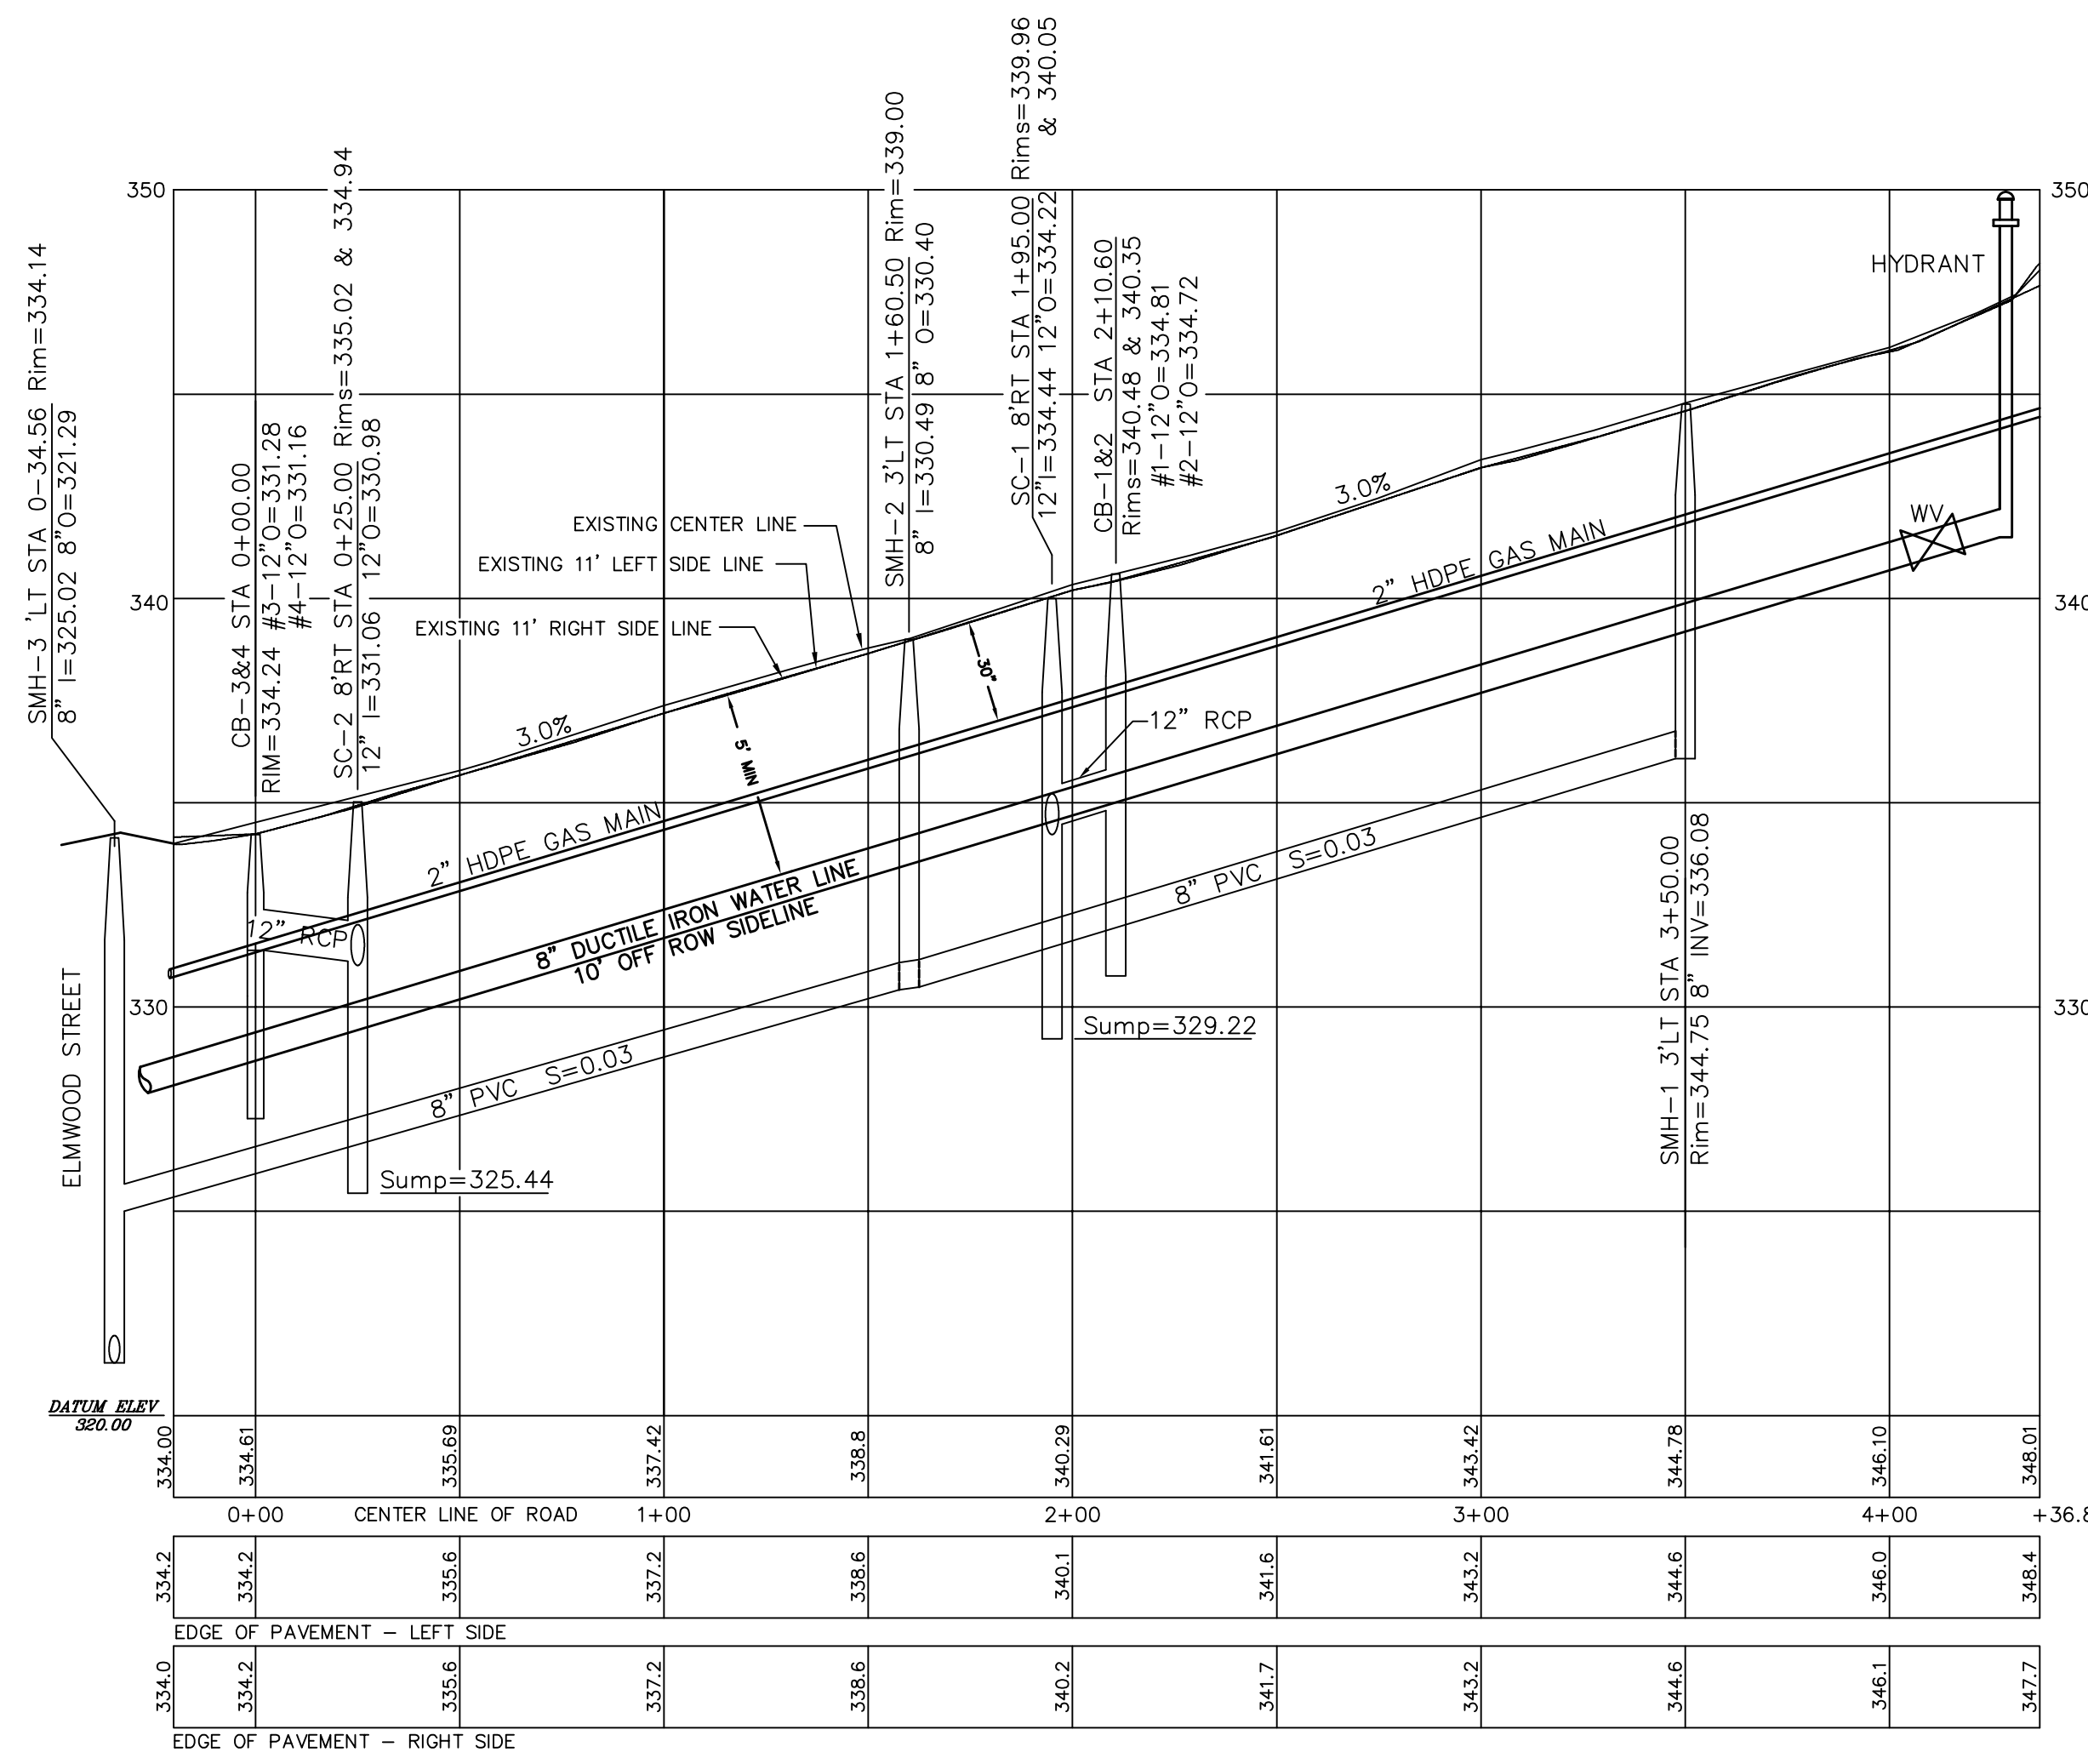

ROAD PROFILE  
 HORIZONTAL SCALE: 1"=40'  
 VERTICAL SCALE: 1"=4'

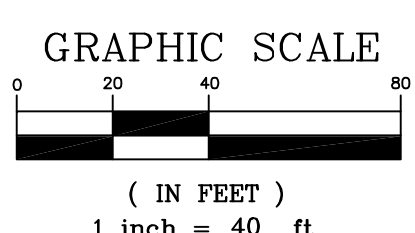

- LEGEND**
- ∞ SW STONE WALL
  - SETBACK LINE
  - HYDRANT
  - WATER SHUTOFF VALVE
  - DRILL HOLE
  - UTILITY POLE
  - STONE BOUND
  - ▣ CONCRETE BOUND
  - ⊙ SMH SEWER MANHOLE
  - ⊙ DMH DRAIN MANHOLE
  - CATCH BASIN

THIS PLAN IS THE RESULT OF AN ON THE GROUND SURVEY PERFORMED BY THIS OFFICE AND ADDITIONAL INFORMATION PROVIDED BY OTHERS.

JON L. FAGERSTROM DATE:  
 P.L.S. #49205

"AS BUILT" PLAN  
 DESROSIERS LANDING  
 IN  
 GRAFTON, MA.  
 OWNED BY  
 CHARLES KADY, Jr.  
 129 CHARLTON ROAD  
 SPENCER, MA 01562

**ALPHA OMEGA**  
 ENGINEERING INC.  
 CIVIL ENGINEERS • LAND SURVEYORS  
 ENVIRONMENTAL CONSULTANTS  
 25 HIGHLAND VIEW DR  
 SUTTON, MA 01980  
 508-865-9551

WWW.ALPHAOMEGAENG.NET  
 INFO@ALPHAOMEGAENG.NET

AUGUST 21, 2019

SHEET 1 OF 1