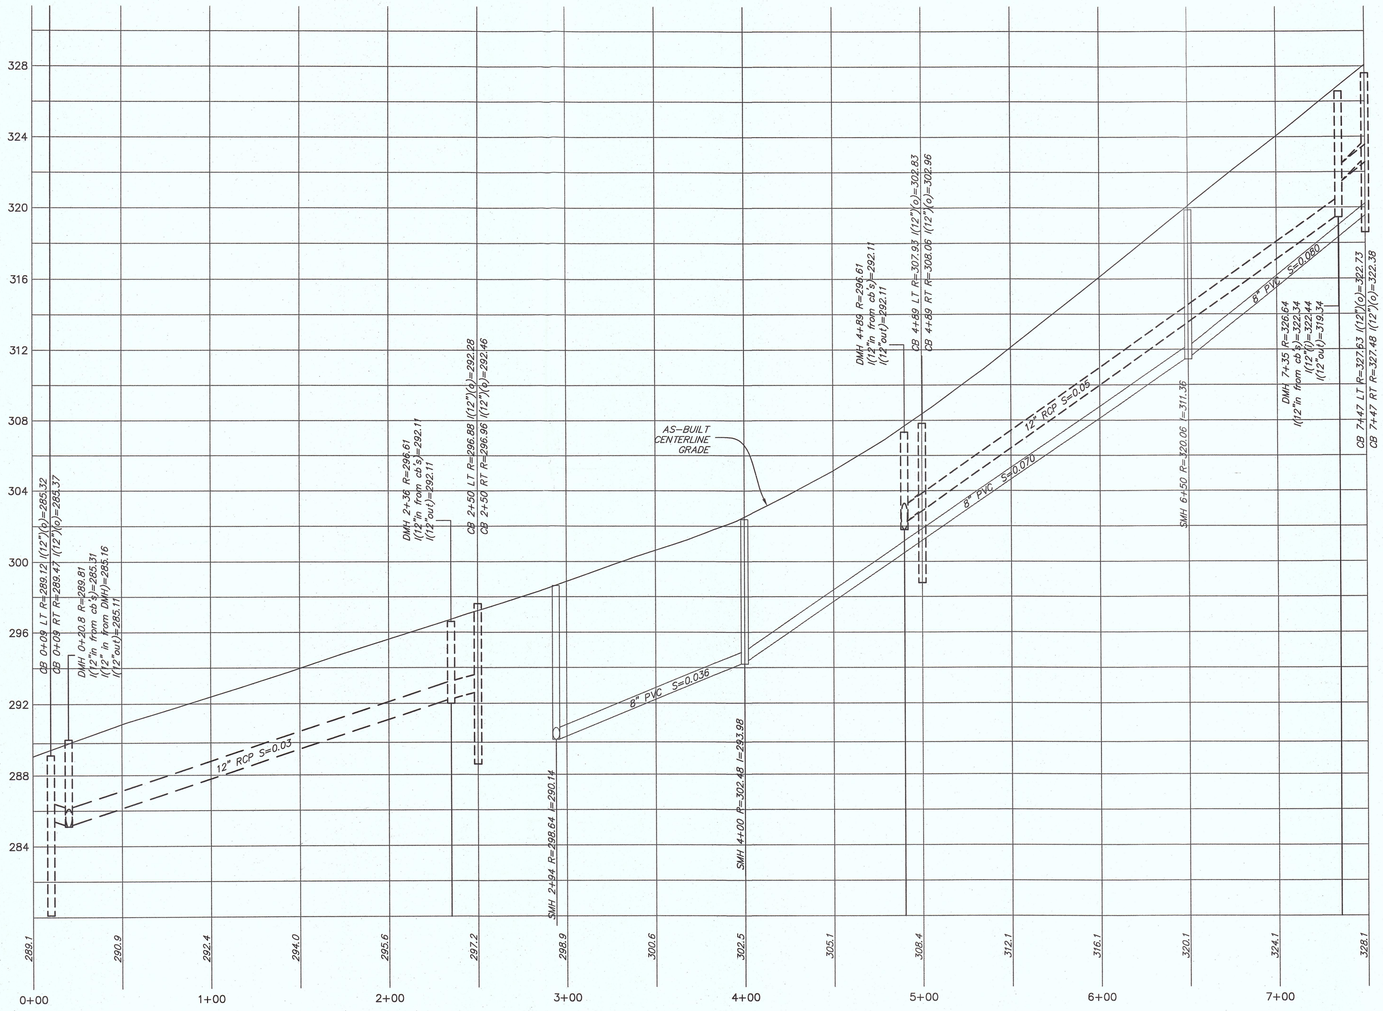

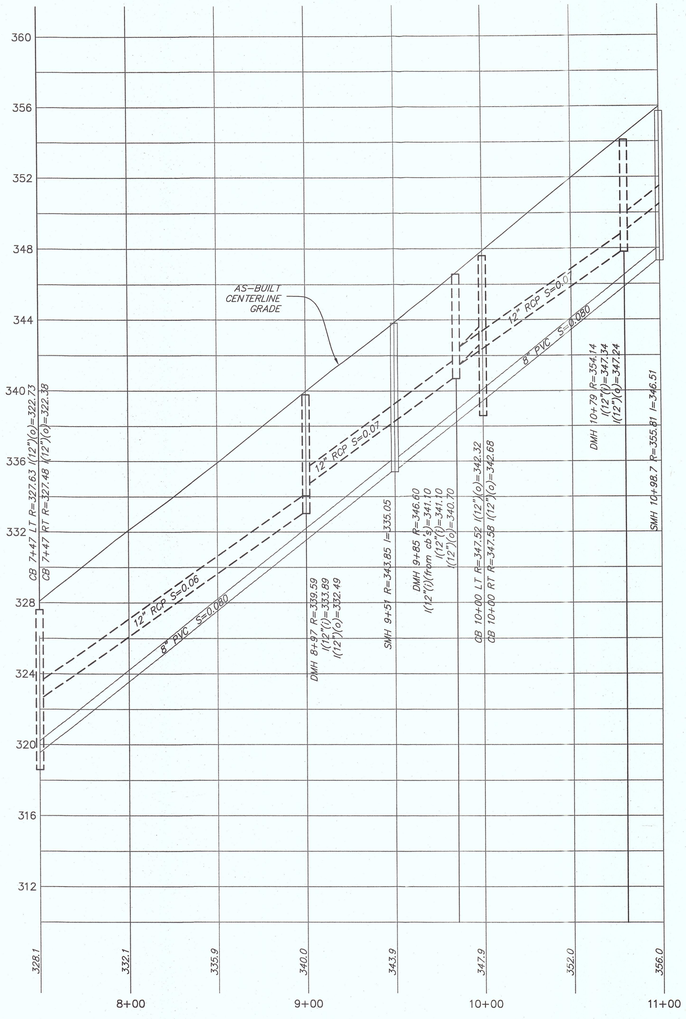

SEWER & DRAIN PROFILE
1"=40' HOR., 1"=4' VERT.

"WARNING"
EXISTING UTILITY LINES INDICATED OR NOTED ON THESE DRAWINGS ARE SHOWN AS OBTAINED FROM EXISTING INFORMATION AND ARE ONLY APPROXIMATE IN LOCATION. THE CONTRACTOR SHALL TAKE CAUTION IN THESE AREAS TO AVOID DAMAGE TO EXISTING UTILITY LINES AND/OR HARM TO PERSONNEL ENGAGED IN WORKING IN THESE AREAS. CALL "DIG SAFE" 1-888-344-7233.

EXISTING LINES OTHER THAN THOSE INDICATED ON THESE DRAWINGS MAY BE ON THE SITE. THE CONTRACTOR IS WARNED TO PROCEED WITH CAUTION WITH ALL WORK, ESPECIALLY EXCAVATION WORK. HE IS TO MAKE ALL POSSIBLE INVESTIGATIONS AS TO POSSIBLE UNMARKED UTILITY LINES.

NOTES:

1) ELEVATIONS REFER TO THE NATIONAL GEODETIC VERTICAL DATUM OF 1988.

2) STORM DRAIN SHOWN DASHED.

"I CERTIFY THIS PLAN IS BASED ON AN ON THE GROUND SURVEY."

COMMONWEALTH OF MASSACHUSETTS
NORMAND T. GAMACHE JR.
NO. 34615
PROFESSIONAL LAND SURVEYOR

Professional Land Surveyor

March 30, 2016
Date

NOTE: CONSTRUCTION ON THIS LOT(OR LAND) IS SUBJECT TO ANY EASEMENTS, RIGHTS OF WAY, RESTRICTIONS, RESERVATIONS OR OTHER LIMITATIONS WHICH MAY BE REVEALED BY AN EXAMINATION OF THE TITLE.

DATE	REVISION	INIT

OWNER/APPLICANT

BROOKMEADOW VILLAGE, LLC
67 CAPE ROAD
MENDON, MA. 01756

AS-BUILT PROFILE
OF
BROOKMEADOW LANE
SHOWING SEWER MAIN
AND STORM DRAIN
IN
"BROOKMEADOW VILLAGE"
GRAFTON, MASS.

DATE: MARCH 25, 2016
SCALE: 1"=40'
0 20 40 FEET 80 120
0 2 10 20 METERS 40

FILE

RECEIVED
APR 1 2016
PLANNING BOARD
GRAFTON, MA

Guerriere & Halnon, Inc.
Engineering & Land Surveying
1029 PROVIDENCE ROAD, WHITINSVILLE, MASS. 01588
(508) 234-6834 FAX: (508) 234-6723
WWW.GUERRIEREANDHALNON.COM

CPH

SHEET 1 OF 2

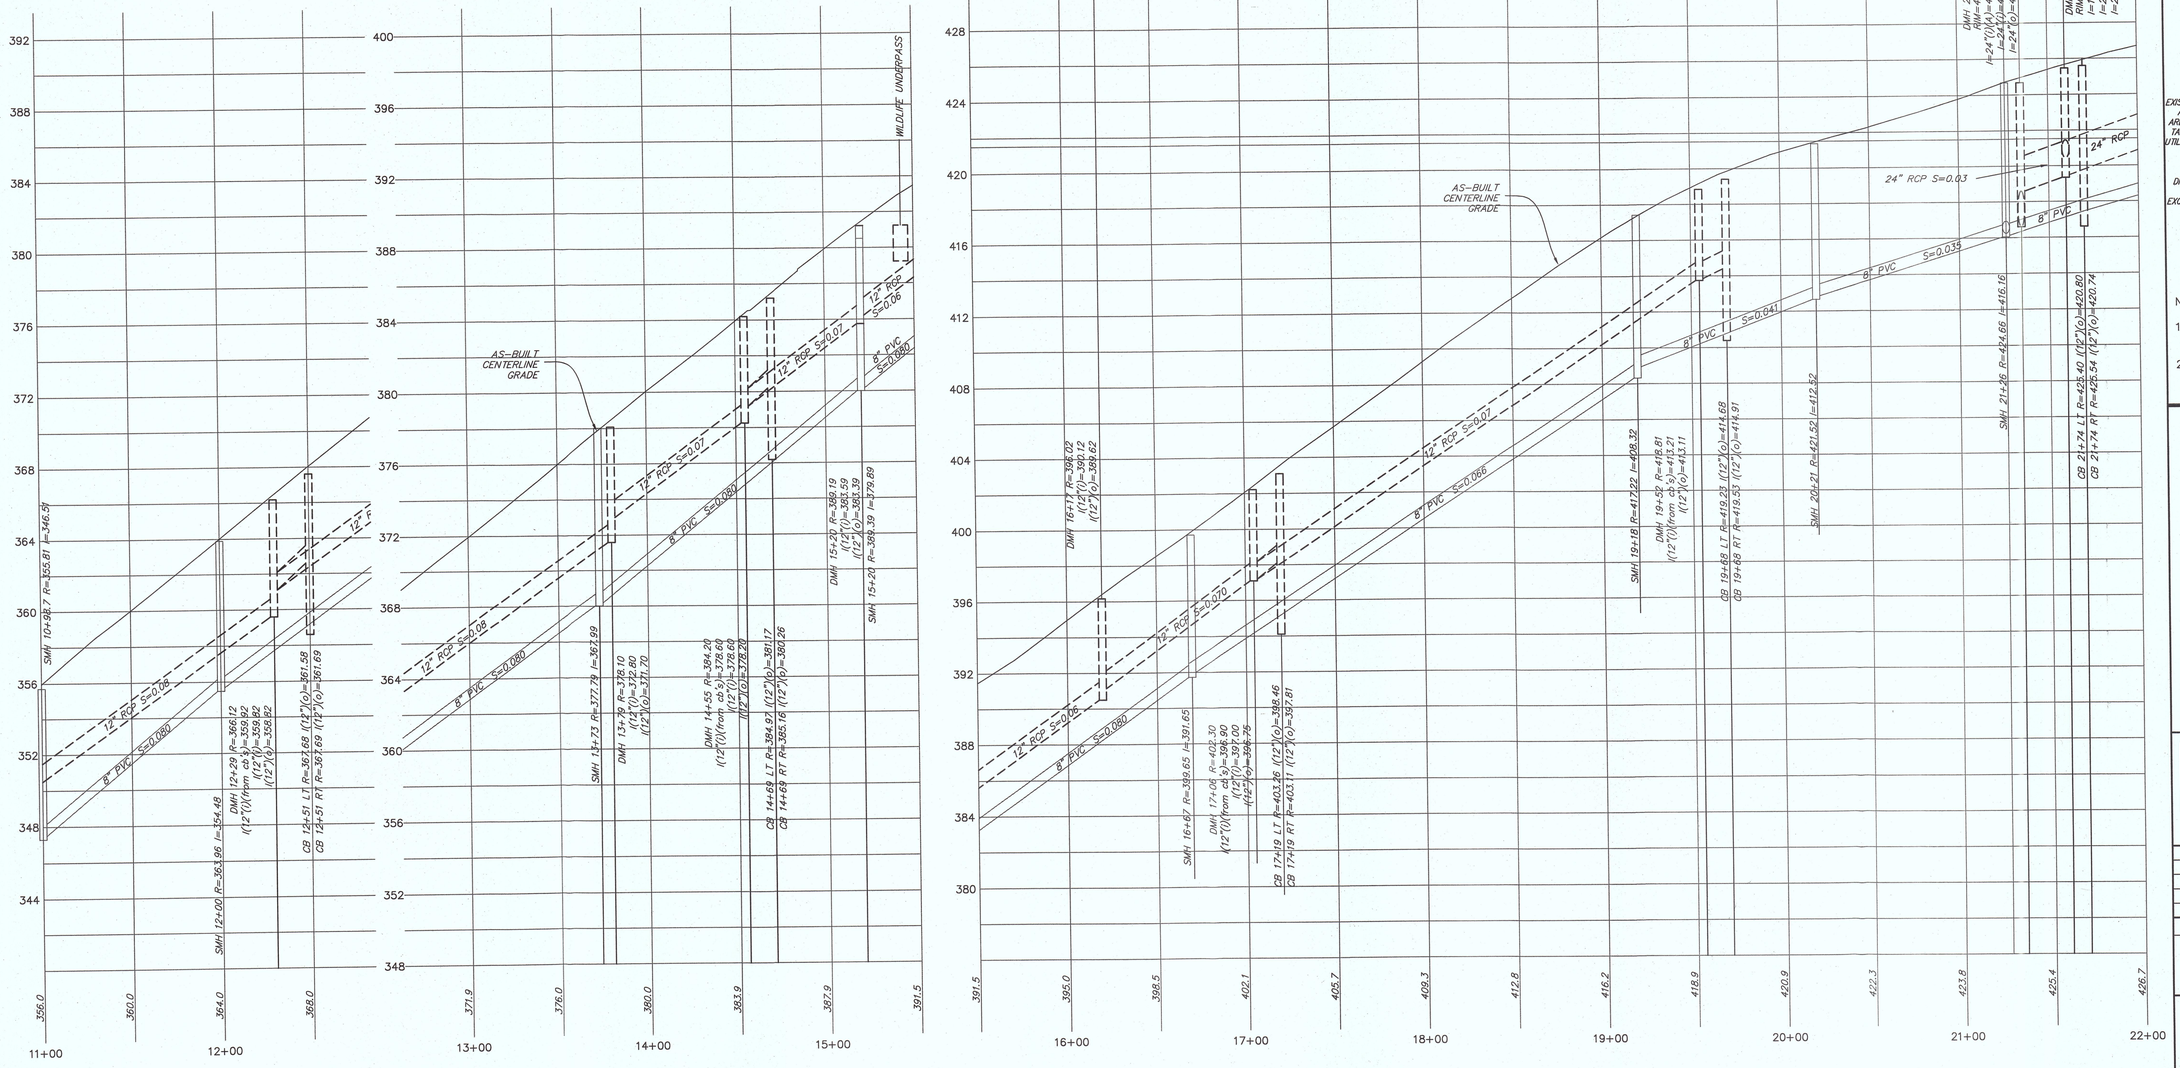

SEWER & DRAIN PROFILE
1"=40' HOR., 1"=4' VERT.

"WARNING"

EXISTING UTILITY LINES INDICATED OR NOTED ON THESE DRAWINGS ARE SHOWN AS OBTAINED FROM EXISTING INFORMATION AND ARE ONLY APPROXIMATE IN LOCATION. THE CONTRACTOR SHALL TAKE CAUTION IN THESE AREAS TO AVOID DAMAGE TO EXISTING UTILITY LINES AND/OR HARM TO PERSONNEL ENGAGED IN WORKING IN THESE AREAS. CALL "DIG SAFE" 1-888-344-7233.

EXISTING LINES OTHER THAN THOSE INDICATED ON THESE DRAWINGS MAY BE ON THE SITE. THE CONTRACTOR IS WARNED TO PROCEED WITH CAUTION WITH ALL WORK ESPECIALLY EXCAVATION WORK. HE IS TO MAKE ALL POSSIBLE INVESTIGATIONS AS TO POSSIBLE UNMARKED UTILITY LINES.

NOTES:

1) ELEVATIONS REFER TO THE NATIONAL GEODETIC VERTICAL DATUM OF 1988.

2) STORM DRAIN SHOWN DASHED.

"I CERTIFY THIS PLAN IS BASED ON AN ON THE GROUND SURVEY."

COMMONWEALTH OF MASSACHUSETTS
NORMAND GAMACHE JR. NO. 34615
PROFESSIONAL LAND SURVEYOR

Normand T. Gamache
Professional Land Surveyor

March 30, 2016
Date

NOTE: CONSTRUCTION ON THIS LOT(OR LAND) IS SUBJECT TO ANY EASEMENTS, RIGHTS OF WAY, RESTRICTIONS, RESERVATIONS OR OTHER LIMITATIONS WHICH MAY BE REVEALED BY AN EXAMINATION OF THE TITLE.

DATE	REVISION	INIT

OWNER/APPLICANT

BROOKMEADOW VILLAGE, LLC
67 CAPE ROAD
MENDON, MA. 01756

AS-BUILT PROFILE
OF
BROOKMEADOW LANE
SHOWING SEWER MAIN
AND STORM DRAIN
IN
"BROOKMEADOW VILLAGE"
GRAFTON, MASS.

SCALE: 1"= 40'
DATE: MARCH 25, 2016
SCALE: 1"=40'

0 20 40 FEET 80 120
0 2 10 20 METERS 40

Guerriere & Halnon, Inc.
Engineering & Land Surveying
1029 PROVIDENCE ROAD, WHITINSVILLE, MASS. 01588
(508) 234-6834 FAX: (508) 234-6723
WWW.GUERRIEREANDHALNON.COM

CPH

SHEET 2 OF 2

W-2118

W-2118

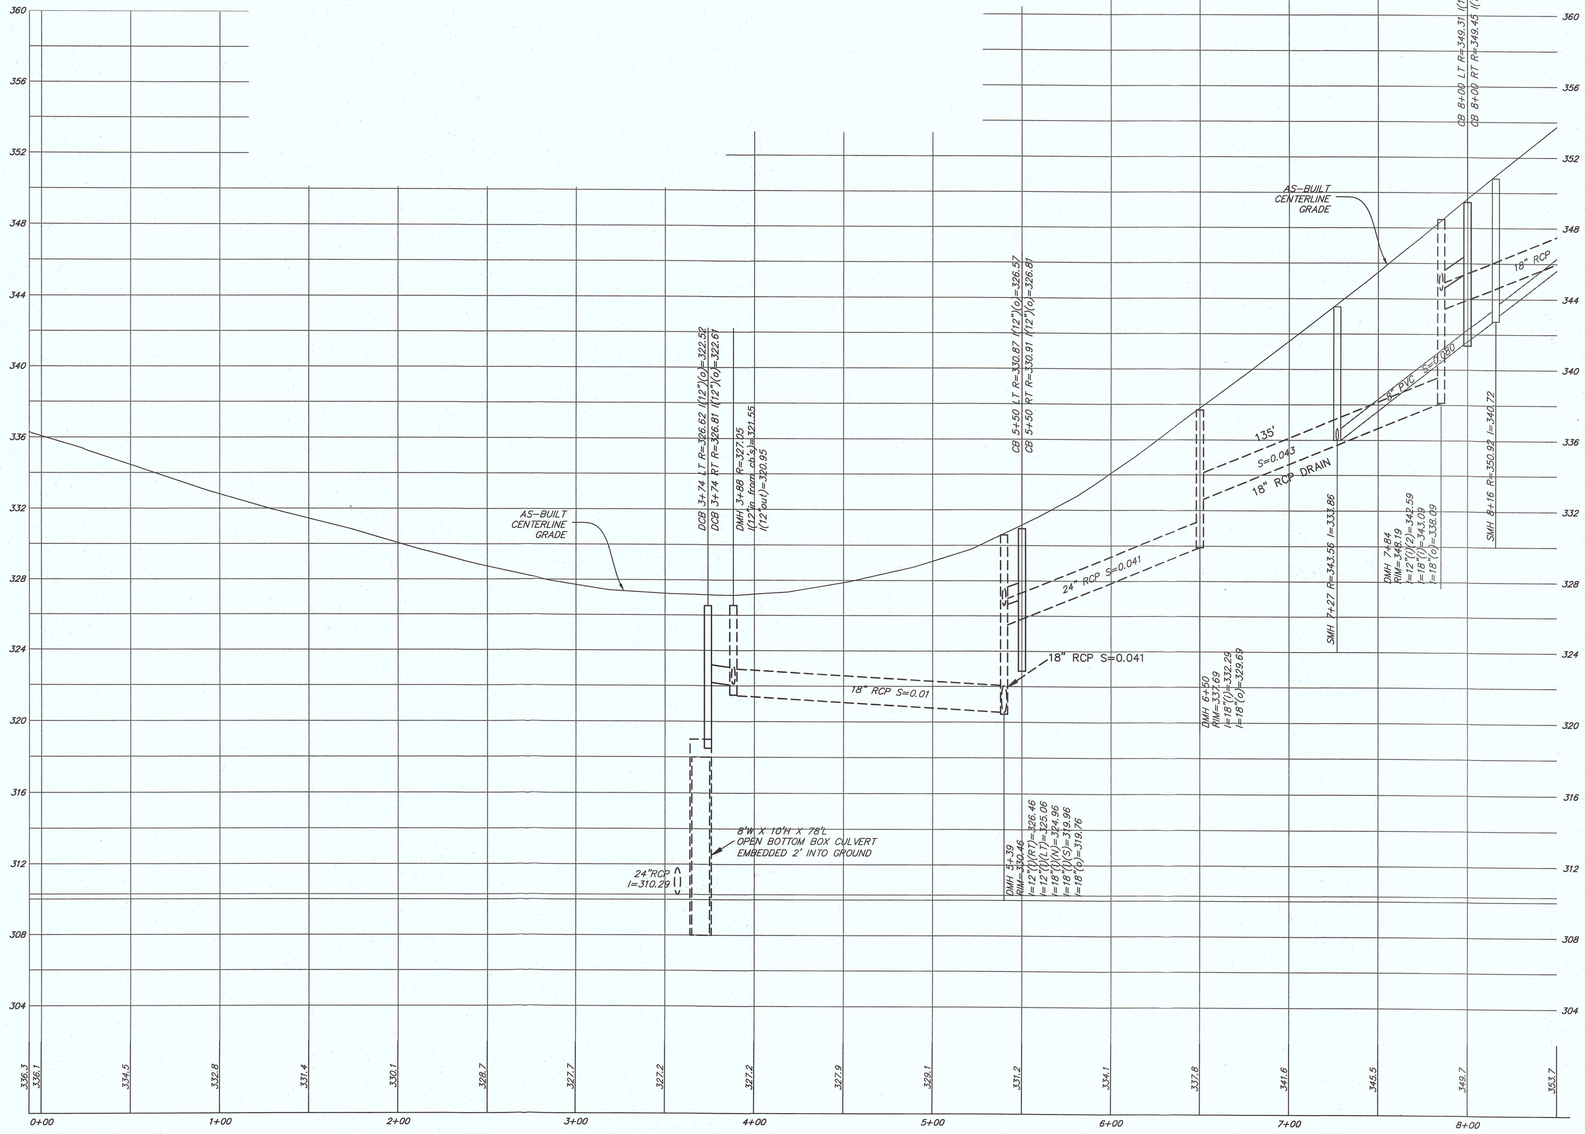

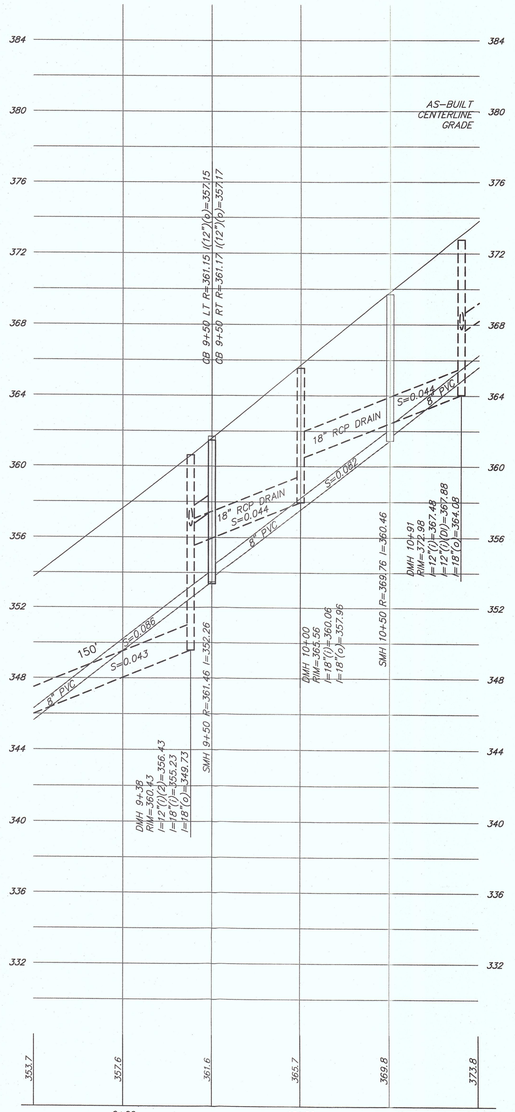

SEWER & DRAIN PROFILE
1"=40' HOR., 1"=4' VERT.

"WARNING"
EXISTING UTILITY LINES INDICATED OR NOTED ON THESE DRAWINGS ARE SHOWN AS OBTAINED FROM EXISTING INFORMATION AND ARE ONLY APPROXIMATE IN LOCATION. THE CONTRACTOR SHALL TAKE CAUTION IN THESE AREAS TO AVOID DAMAGE TO EXISTING UTILITY LINES AND/OR HARM TO PERSONNEL ENGAGED IN WORKING IN THESE AREAS. CALL "DIG SAFE" 1-888-344-7233.

EXISTING LINES OTHER THAN THOSE INDICATED ON THESE DRAWINGS MAY BE ON THE SITE. THE CONTRACTOR IS WARNED TO PROCEED WITH CAUTION WITH ALL WORK. ESPECIALLY EXCAVATION WORK. HE IS TO MAKE ALL POSSIBLE INVESTIGATIONS AS TO POSSIBLE UNMARKED UTILITY LINES.

NOTES:

1) ELEVATIONS REFER TO THE NATIONAL GEODETIC VERTICAL DATUM OF 1988.

2) STORM DRAIN SHOWN DASHED.

"I CERTIFY THIS PLAN IS BASED ON AN ON THE GROUND SURVEY."

COMMONWEALTH OF MASSACHUSETTS
NORMAND GAMACHE JR. NO. 34615
PROFESSIONAL LAND SURVEYOR

Normand T. Gamache
Professional Land Surveyor

March 30, 2016
Date

NOTE: CONSTRUCTION ON THIS LOT(OR LAND) IS SUBJECT TO ANY EASEMENTS, RIGHTS OF WAY, RESTRICTIONS, RESERVATIONS OR OTHER LIMITATIONS WHICH MAY BE REVEALED BY AN EXAMINATION OF THE TITLE.

DATE	REVISION	INIT

OWNER/APPLICANT

BROOKMEADOW VILLAGE, LLC
67 CAPE ROAD
MENDON, MA. 01756

AS-BUILT PROFILE
OF
TAFT MILL ROAD
SHOWING SEWER MAIN
AND STORM DRAIN
IN
"BROOKMEADOW VILLAGE"
GRAFTON, MASS.

SCALE: 1"= 40'
DATE: MARCH 25, 2016

SCALE: 1"=40'
0 20 40 FEET 80 120
0 2 10 20 METERS 40

Guerriere & Halnon, Inc.
Engineering & Land Surveying
1029 PROVIDENCE ROAD, WHITINSVILLE, MASS. 01588
(508) 234-6834 FAX: (508) 234-6723
WWW.GUERRIEREANDHALNON.COM

CPH

SHEET 1 OF 3

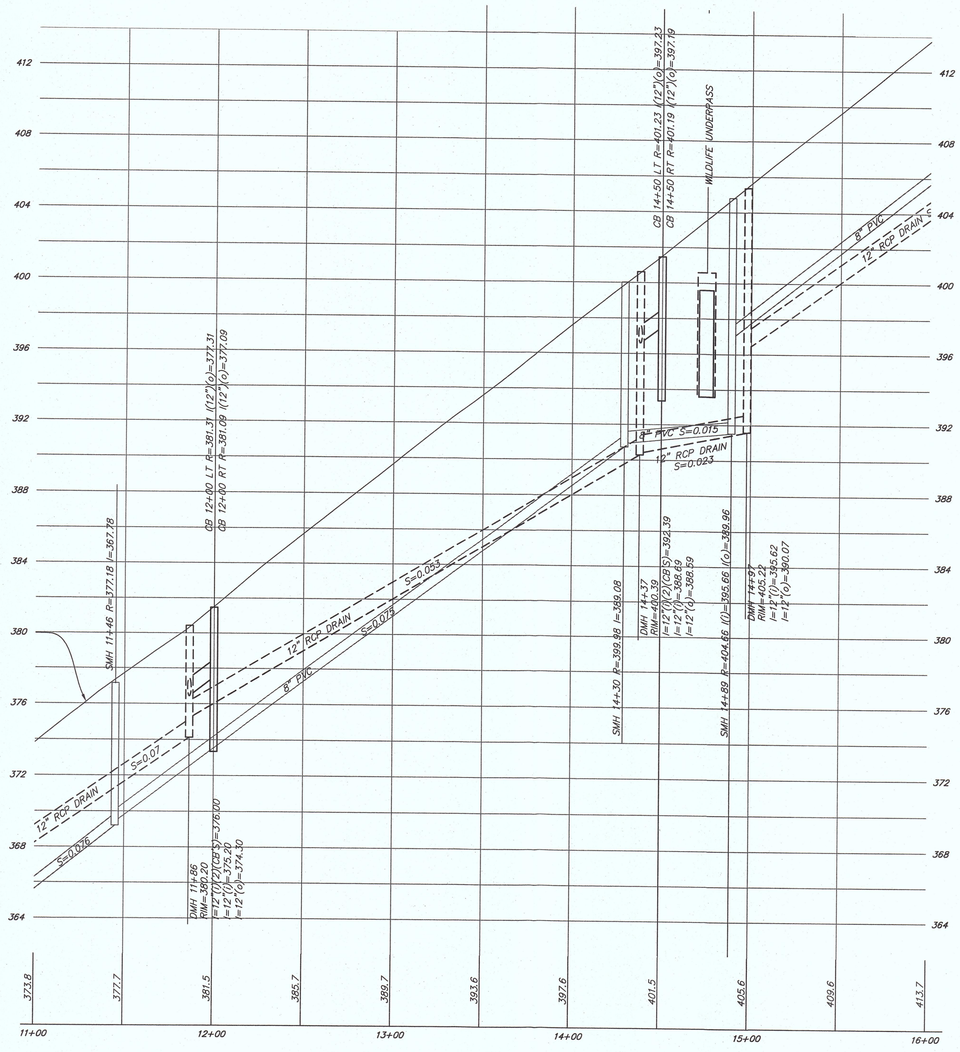

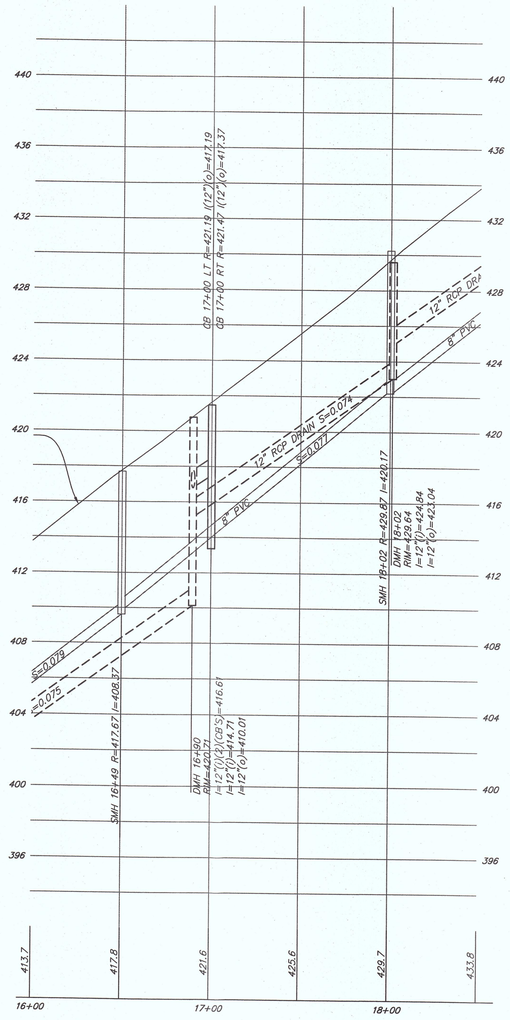

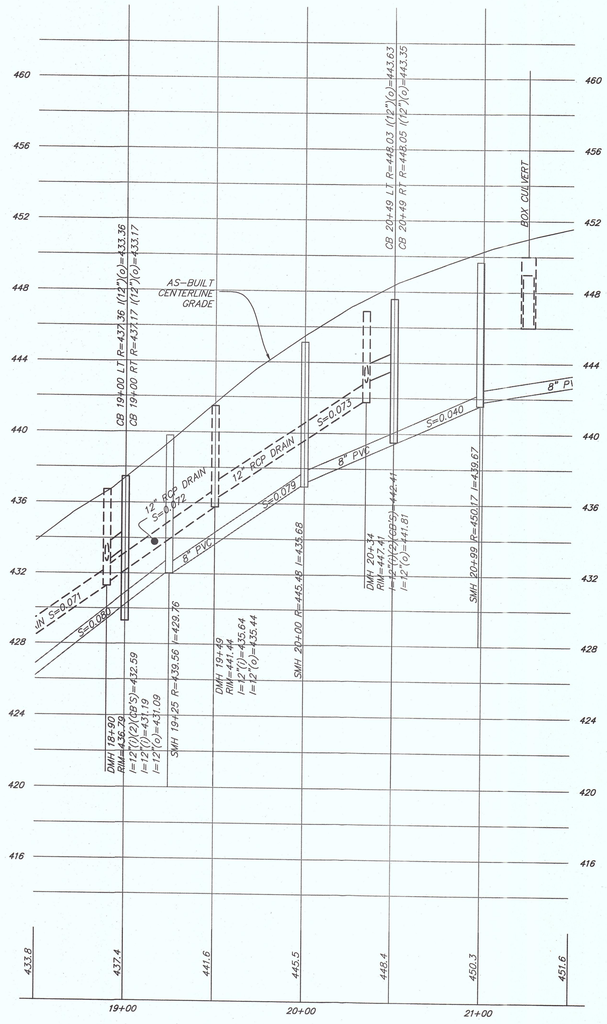

SEWER & DRAIN PROFILE
1"=40' HOR., 1"=4' VERT.

"WARNING"
EXISTING UTILITY LINES INDICATED OR NOTED ON THESE DRAWINGS ARE SHOWN AS OBTAINED FROM EXISTING INFORMATION AND ARE ONLY APPROXIMATE IN LOCATION. THE CONTRACTOR SHALL TAKE CAUTION IN THESE AREAS TO AVOID DAMAGE TO EXISTING UTILITY LINES AND/OR HARM TO PERSONNEL ENGAGED IN WORKING IN THESE AREAS. CALL "DIG SAFE" 1-888-344-7233.

EXISTING LINES OTHER THAN THOSE INDICATED ON THESE DRAWINGS MAY BE ON THE SITE. THE CONTRACTOR IS WARNED TO PROCEED WITH CAUTION WITH ALL WORK. ESPECIALLY EXCAVATION WORK. HE IS TO MAKE ALL POSSIBLE INVESTIGATIONS AS TO POSSIBLE UNMARKED UTILITY LINES.

NOTES:

1) ELEVATIONS REFER TO THE NATIONAL GEODETIC VERTICAL DATUM OF 1988.

2) STORM DRAIN SHOWN DASHED.

"I CERTIFY THIS PLAN IS BASED ON AN ON THE GROUND SURVEY."

COMMONWEALTH OF MASSACHUSETTS
NORMAND T. GAMACHE JR.
NO. 34615
PROFESSIONAL LAND SURVEYOR

Normand T. Gamache
Professional Land Surveyor

March 3, 2016
Date

NOTE: CONSTRUCTION ON THIS LOT(OR LAND) IS SUBJECT TO ANY EASEMENTS, RIGHTS OF WAY, RESTRICTIONS, RESERVATIONS OR OTHER LIMITATIONS WHICH MAY BE REVEALED BY AN EXAMINATION OF THE TITLE.

DATE	REVISION	INIT

OWNER/APPLICANT

BROOKMEADOW VILLAGE, LLC
67 CAPE ROAD
MENDON, MA. 01756

AS-BUILT PROFILE
OF
TAFT MILL ROAD
SHOWING SEWER MAIN
AND STORM DRAIN
IN
"BROOKMEADOW VILLAGE"
GRAFTON, MASS.

SCALE: 1"= 40'
DATE: MARCH 23, 2016

SCALE: 1"=40'
0 20 40 FEET 80 120
0 2 10 20 METERS 40

Guerriere & Halnon, Inc.
Engineering & Land Surveying
1029 PROVIDENCE ROAD, WHITINSVILLE, MASS. 01588
(508) 234-6834 FAX: (508) 234-6723
WWW.GUERRIEREANDHALNON.COM

CPH

SHEET 2 OF 3

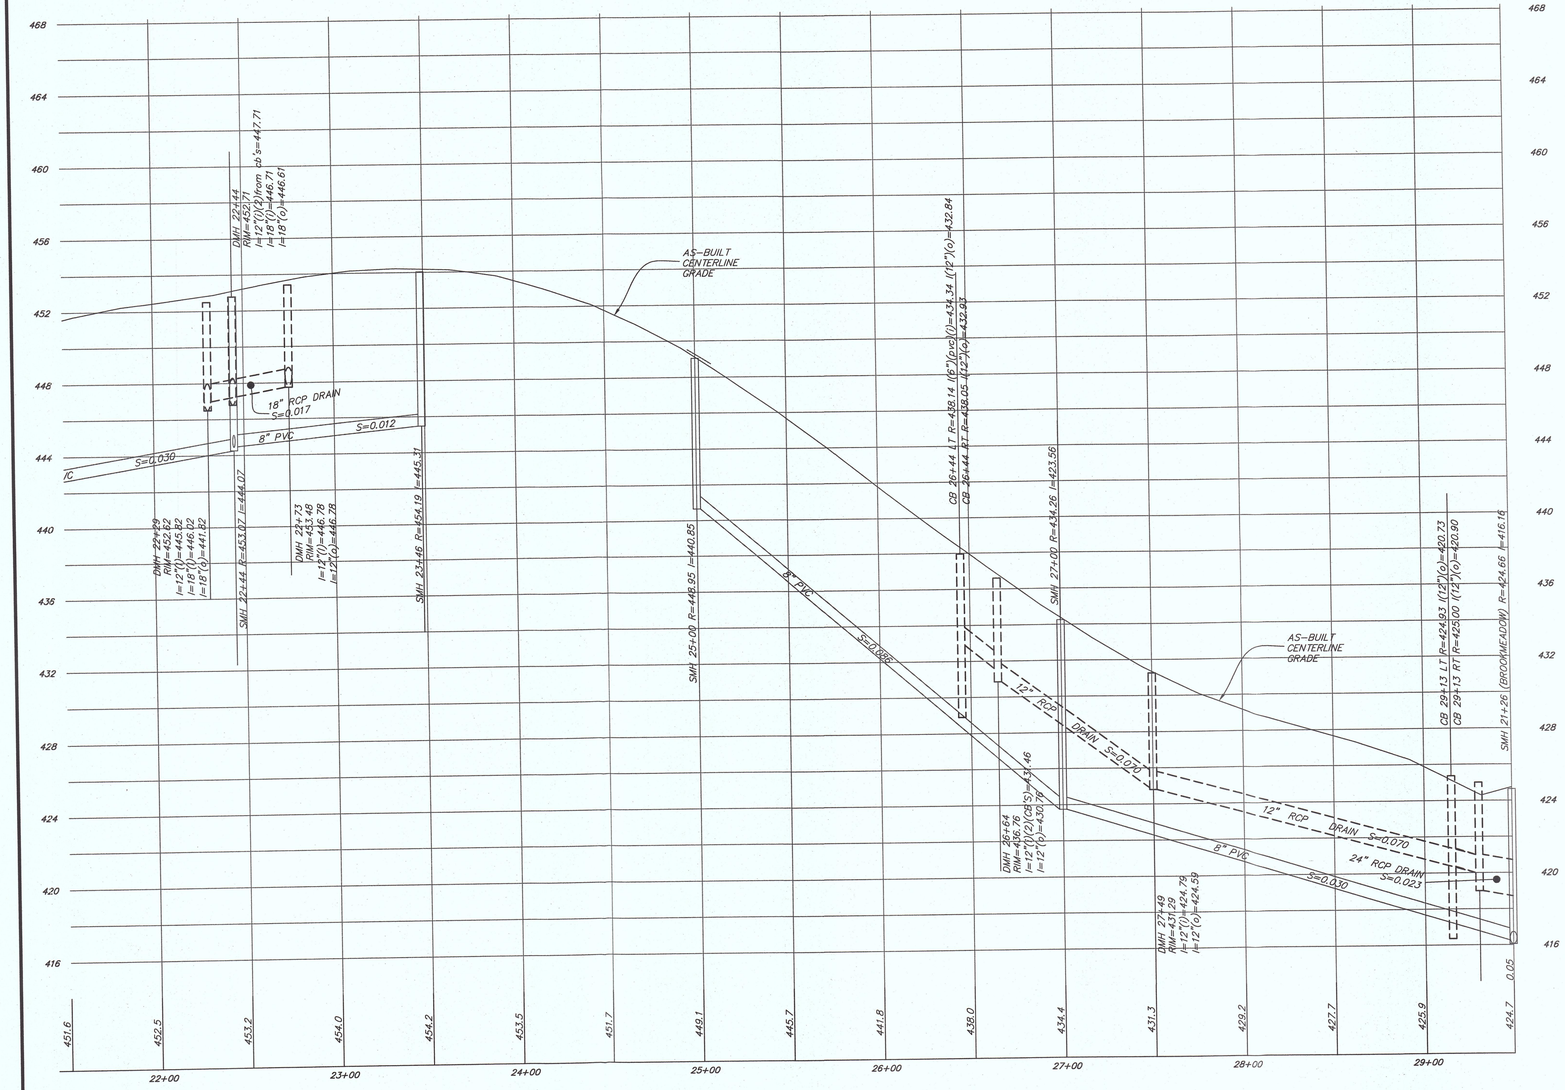

SEWER & DRAIN PROFILE
1"=40' HOR., 1"=4' VERT.

W-2118

"WARNING"

EXISTING UTILITY LINES INDICATED OR NOTED ON THESE DRAWINGS ARE SHOWN AS OBTAINED FROM EXISTING INFORMATION AND ARE ONLY APPROXIMATE IN LOCATION. THE CONTRACTOR SHALL TAKE CAUTION IN THESE AREAS TO AVOID DAMAGE TO EXISTING UTILITY LINES AND/OR HARM TO PERSONNEL ENGAGED IN WORKING IN THESE AREAS. CALL "DIG SAFE" 1-888-344-7233.

EXISTING LINES OTHER THAN THOSE INDICATED ON THESE DRAWINGS MAY BE ON THE SITE. THE CONTRACTOR IS WARNED TO PROCEED WITH CAUTION WITH ALL WORK. ESPECIALLY EXCAVATION WORK. HE IS TO MAKE ALL POSSIBLE INVESTIGATIONS AS TO POSSIBLE UNMARKED UTILITY LINES.

NOTES:

1) ELEVATIONS REFER TO THE NATIONAL GEODETIC VERTICAL DATUM OF 1988.
2) STORM DRAIN SHOWN DASHED.
3) ALL SEWER LINES ARE PVC.
4) ALL DRAIN LINES SHOWN ARE REINFORCED CONCRETE PIPE

"I CERTIFY THIS PLAN IS BASED ON AN ON THE GROUND SURVEY."

COMMONWEALTH OF MASSACHUSETTS
NORMAND T. GAMACHE JR. NO. 34015 PROFESSIONAL LAND SURVEYOR

Normand T. Gamache
Professional Land Surveyor

March 30, 2016
Date

NOTE: CONSTRUCTION ON THIS LOT(OR LAND) IS SUBJECT TO ANY EASEMENTS, RIGHTS OF WAY, RESTRICTIONS, RESERVATIONS OR OTHER LIMITATIONS WHICH MAY BE REVEALED BY AN EXAMINATION OF THE TITLE.

DATE	REVISION	INIT

OWNER/APPLICANT

BROOKMEADOW VILLAGE, LLC
67 CAPE ROAD
MENDON, MA. 01756

AS-BUILT PROFILE
OF
TAFT MILL ROAD
SHOWING SEWER MAIN
AND STORM DRAIN
IN
"BROOKMEADOW VILLAGE"
GRAFTON, MASS.

SCALE: 1"= 40'
DATE: MARCH 23, 2016

SCALE: 1"=40'
0 20 40 FEET 80 120
0 2 10 20 METERS 40

Guerriere & Halnon, Inc.
Engineering & Land Surveying
1029 PROVIDENCE ROAD, WHITINSVILLE, MASS. 01588
(508) 234-6834 FAX: (508) 234-6723
WWW.GUERRIEREANDHALNON.COM

CPH

SHEET 3 OF 3

W-2118